


LIFTING RODS REMAIN VERTICAL AT ALL TIMES, WITH END CLEATS MOVING WITH RADIUS ROD AND REVERSE LINK

LIFTING ROD RESTRAINT ON CHASSIS

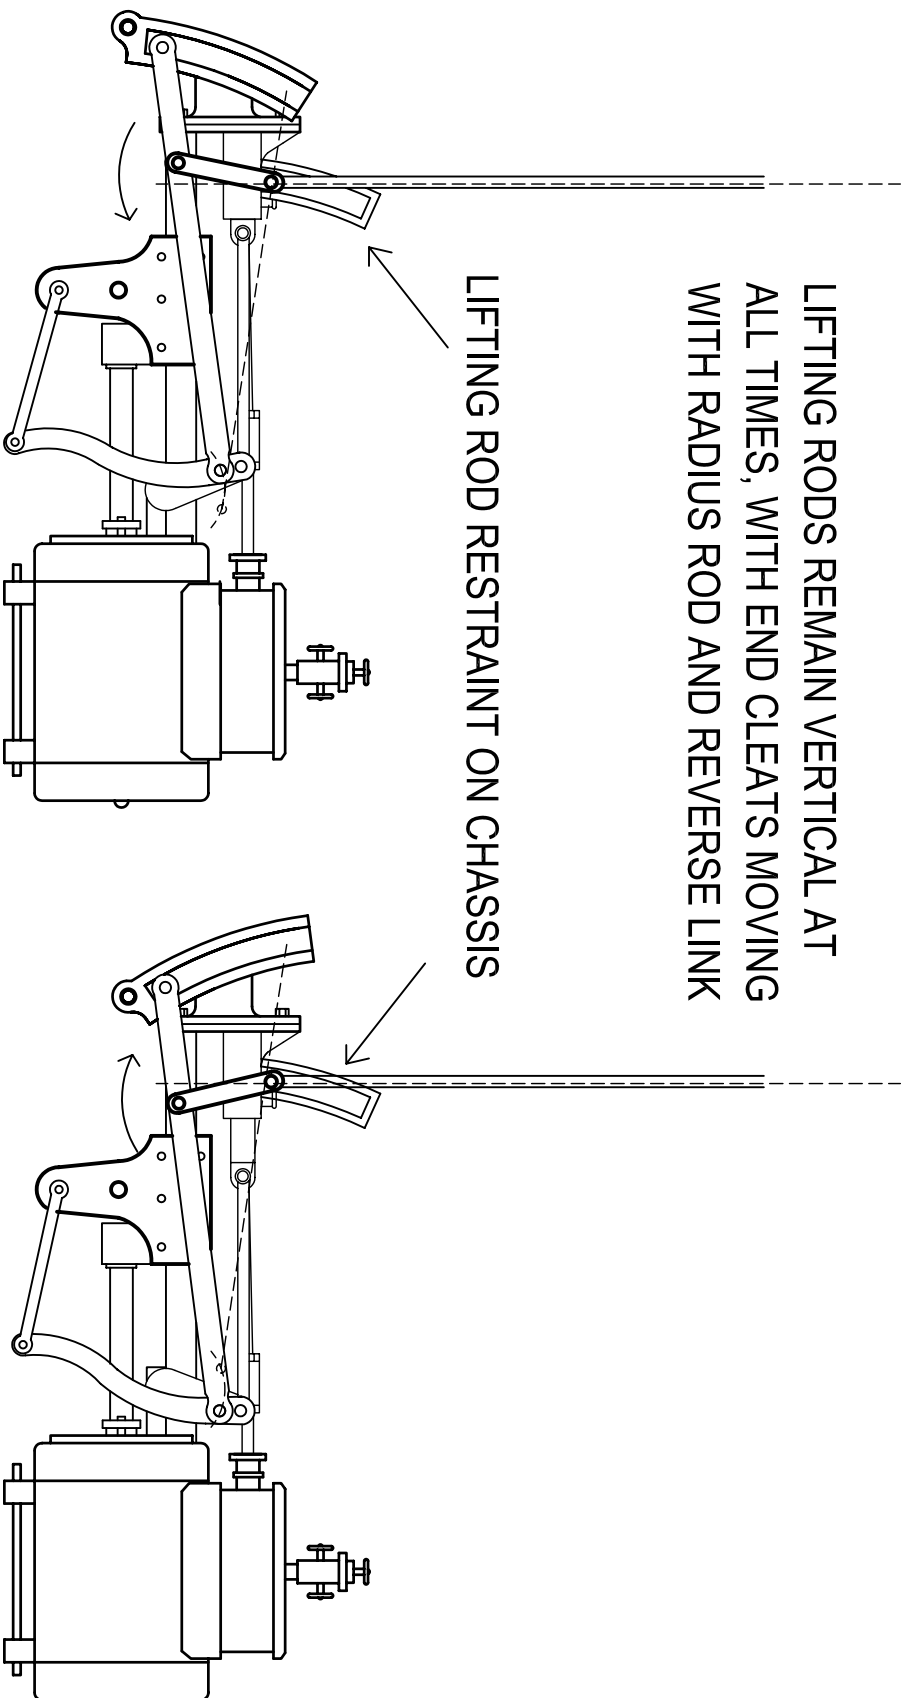

AS-BUILT 2-6-6T MASON LIFTING RODS

